

2025.11.20
23773
EX 1.0
MCGARNER




LEGEND:

- FP FLOODPLAIN (PER 2017 ELEVATION)
- 700 EXISTING (AFTER FILL) CONTOUR
- 700 2017 CONTOUR

Elevations Table			
Number	Minimum Elevation	Maximum Elevation	Color
1	-0.50	0.00	Red
2	0.00	1.00	Yellow
3	1.00	2.00	Blue
4	2.00	3.60	Purple


FILL VOLUME BELOW BFE (700.50): 46 CUBIC YARDS

SIGMA GROUP
 Single Source. Sound Solutions.
 www.thesigmagroup.com
 1300 West Canal Street
 Milwaukee, WI 53233
 Phone: 414-643-4200
 Fax: 414-643-4210

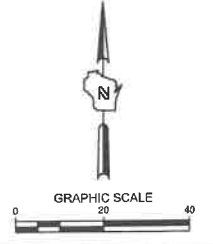

FLOODPLAIN PER 2017 ELEVATIONS ELEV.: 700.50

CROSS SECTION "T" PER FEMA ELEV.=700.50

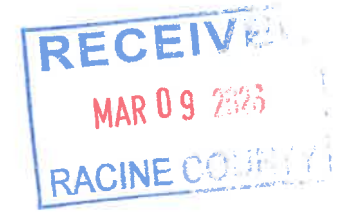

RIV/CRETE READYMIX
 2221 RAYMOND AVE
 YORKVILLE, WI

EXISTING FLOODPLAIN FILL EXHIBIT

**PRELIMINARY
 NOT FOR
 CONSTRUCTION**

ISSUANCE	DATE
NO. REVISION	DATE

PROJECT NO:	23773
DESIGN DATE:	—
PLOT DATE:	2025.11.20
DRAWN BY:	MRG
CHECKED BY:	CTC
APPROVED BY:	CTC
SHEET NO:	

EX 1.0

2026.01.14

MGARNER

EX 4.0

23773



LEGEND:

— FP — FLOODPLAIN (PER ASBUILT CONDITIONS)


— EXISTING (AFTER FILL) CONTOUR

- - - ASBUILT (AFTER CUT) CONTOUR

ASBUILT CUT VOLUME
BELOW BFE (700.50):
47 CUBIC YARDS

Elevations Table			
Number	Minimum Elevation	Maximum Elevation	Color
1	-1.85	-1.00	Red
2	-1.00	0.00	Orange

SIGMA GROUP
 Single Source. Sound Solutions.
 www.thesigmagroup.com
 1300 West Canal Street
 Milwaukee, WI 53233
 Phone: 414-643-4200
 Fax: 414-643-4210

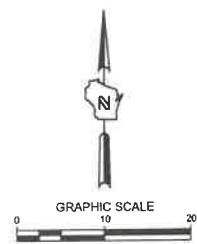

RIV/CRETE READYMIX
 2221 RAYMOND AVE
 YORKVILLE, WI

ASBUILT FLOODPLAIN CUT EXHIBIT


**PRELIMINARY
 NOT FOR
 CONSTRUCTION**

ISSUANCE	DATE
NO. REVISION	DATE

RECEIVED
 MAR 09 2026
 RACINE COUNTY

PROJECT NO:	23773
DESIGN DATE:	—
PLOT DATE:	2026.01.14
DRAWN BY:	MRG
CHECKED BY:	CTC
APPROVED BY:	CTC
SHEET NO:	

EX 4.0

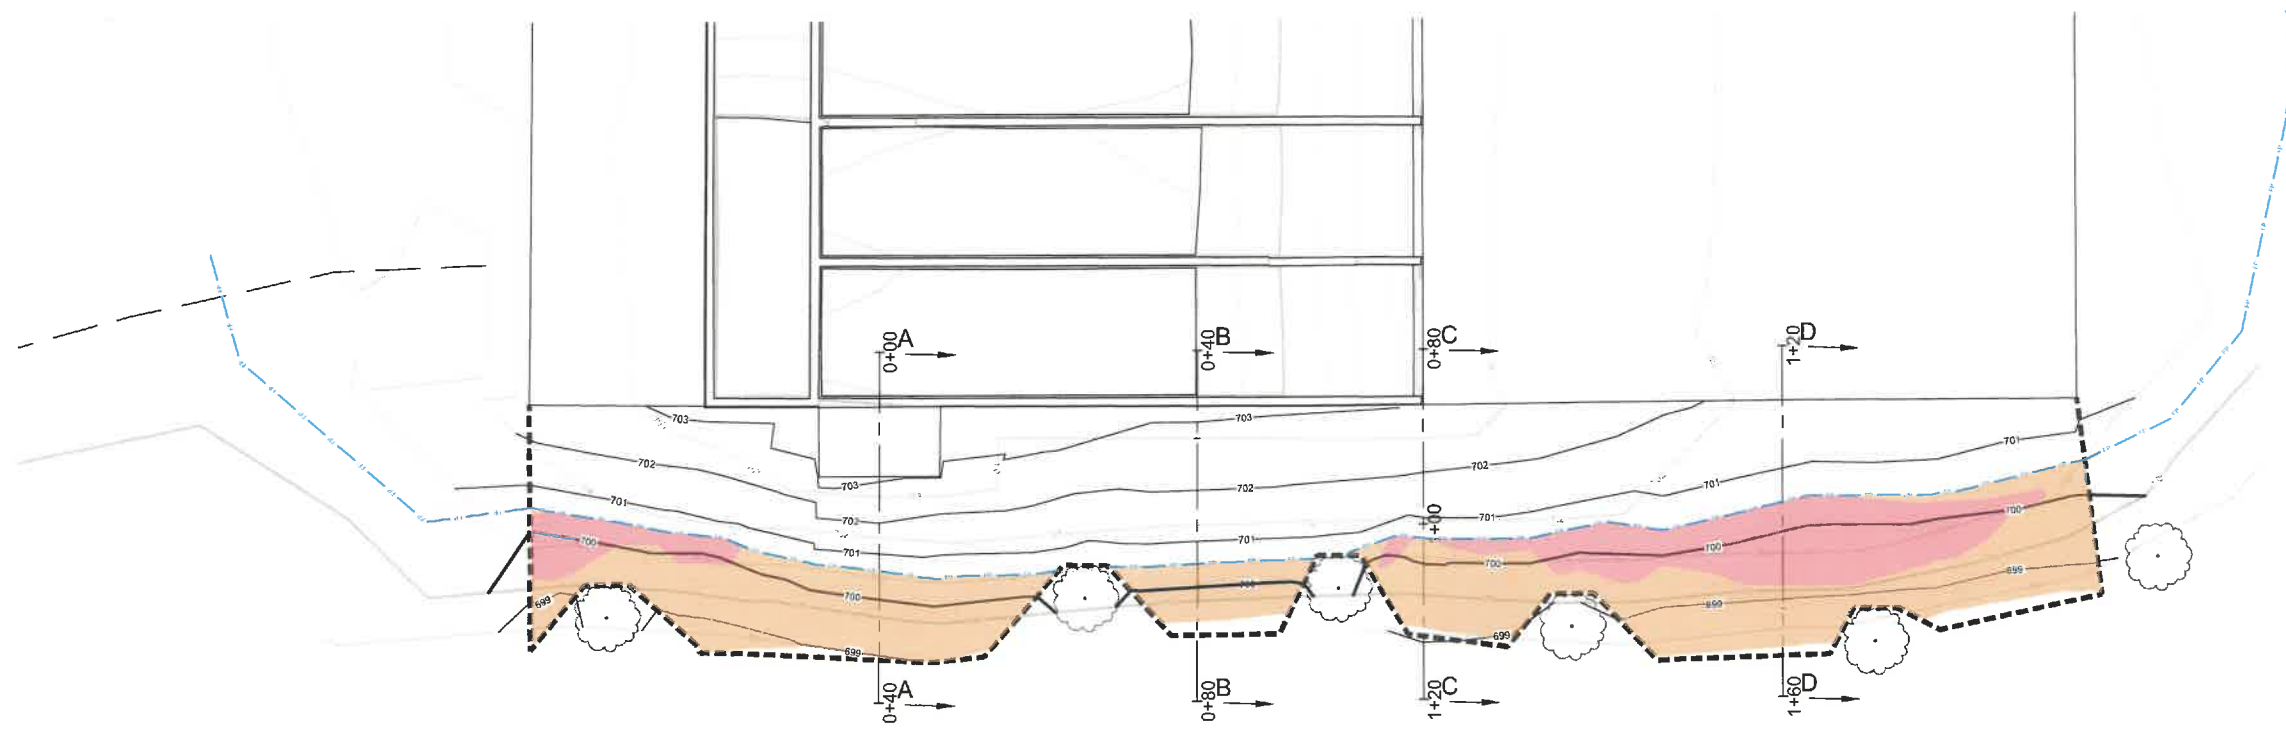


LEGEND:

- FP FLOODPLAIN (PER ASBUILT CONDITIONS)
- EXISTING (AFTER FILL) CONTOUR
- 700 PROPOSED CONTOUR

Elevations Table			
Number	Minimum Elevation	Maximum Elevation	Color
1	-1.65	-1.00	Red
2	-1.00	0.00	Orange


THE SIGMA GROUP
 Single Source. Sound Solutions.
 www.thesigmagroup.com
 1300 West Canal Street
 Milwaukee, WI 53233
 Phone: 414-643-4200
 Fax: 414-643-4210

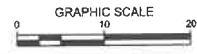

RIV/CRETE READYMIX
 2221 RAYMOND AVE
 YORKVILLE, WI

ASBUILT FLOODPLAIN CUT EXHIBIT X SECTION

X-SECTION SCALE
 HORIZONTAL: 1"=10'
 VERTICAL: 1"=1'

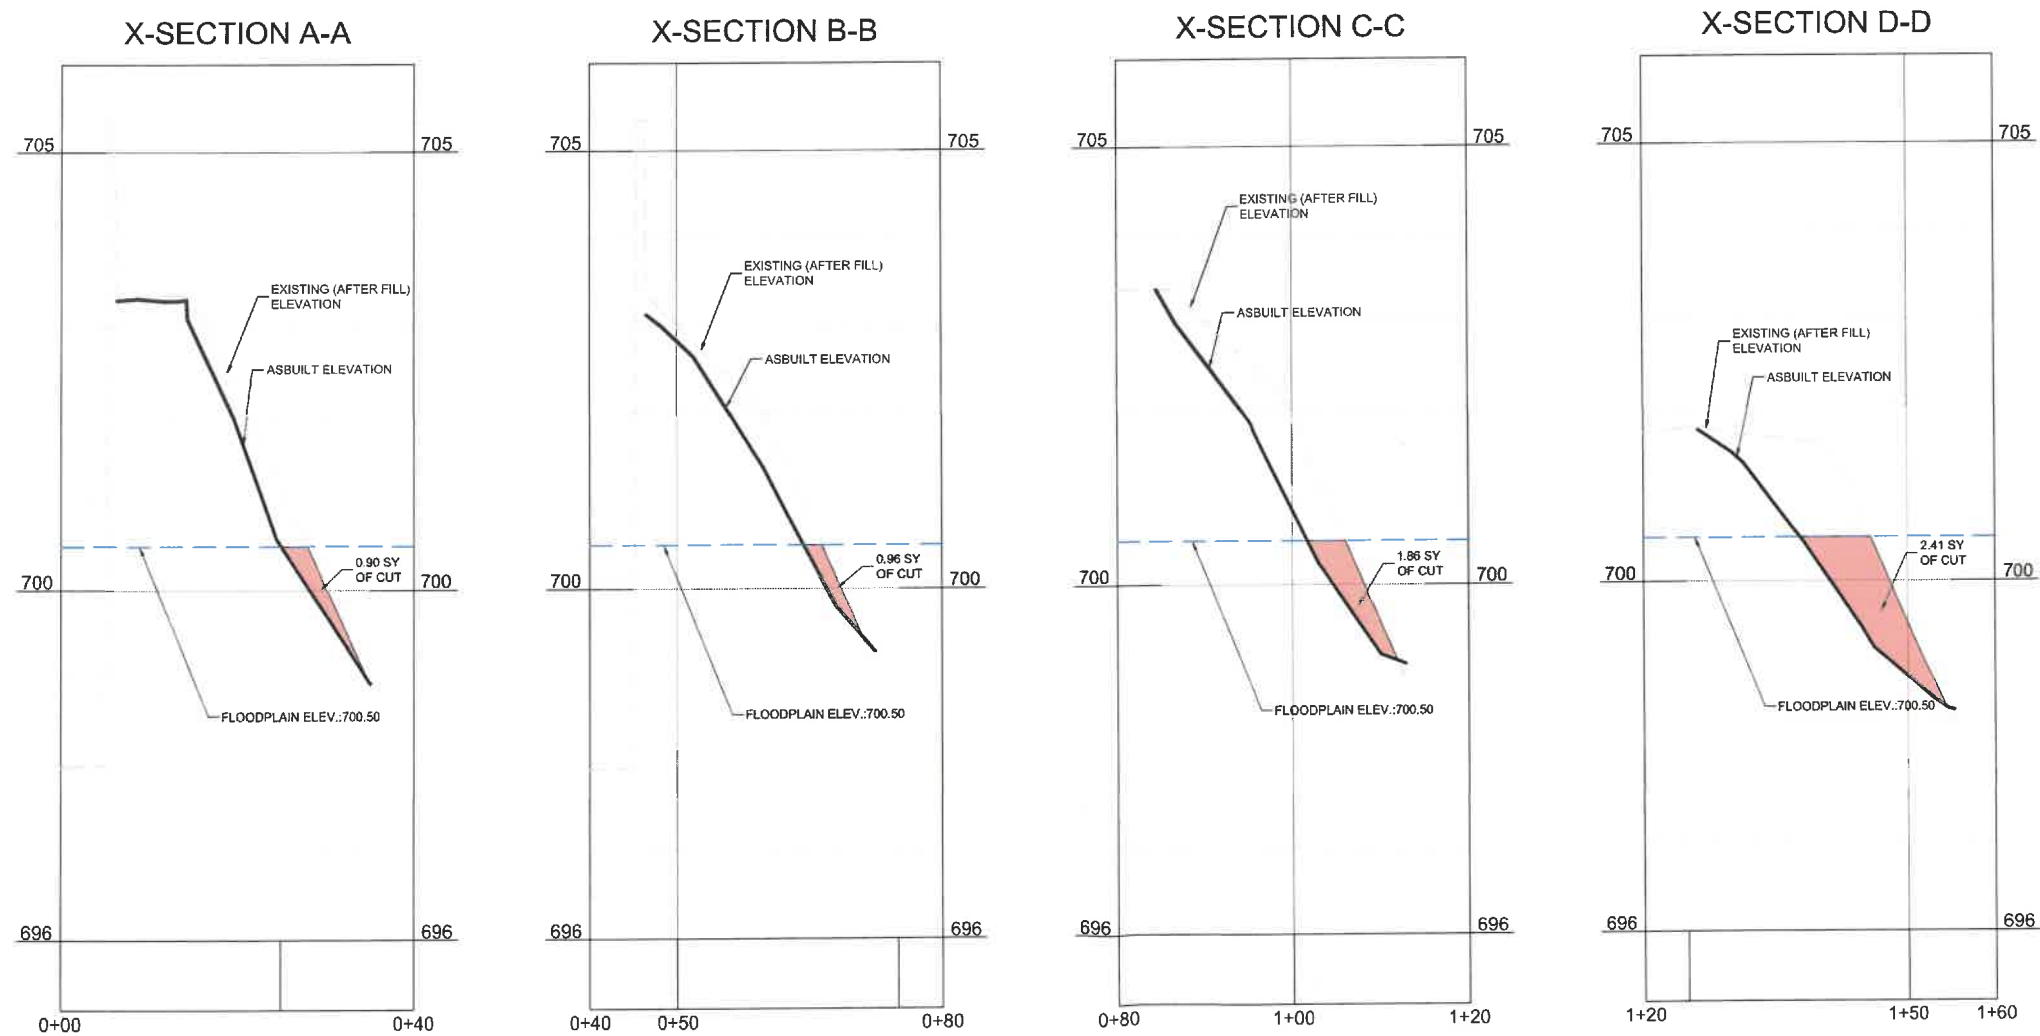

RECEIVED
 MAR 09 2026
 RACINE COUNTY

**PRELIMINARY
 NOT FOR
 CONSTRUCTION**

ISSUANCE	DATE
NO. REVISION	DATE
PROJECT NO:	23773
DESIGN DATE:	
PLOT DATE:	2026.01.14
DRAWN BY:	MRG
CHECKED BY:	CTC
APPROVED BY:	CTC
SHEET NO:	

EX 5.0